B147692

HEAT TREATMENT & FINAL FINISH

PHYSICAL PROPERTIES		DEC. 31, 1941 REVISIONS			
Y.P.		1	CONVERSION 10-30-51		
T.S.					
EL.2					
RED.					
BR.					
ROCK.					

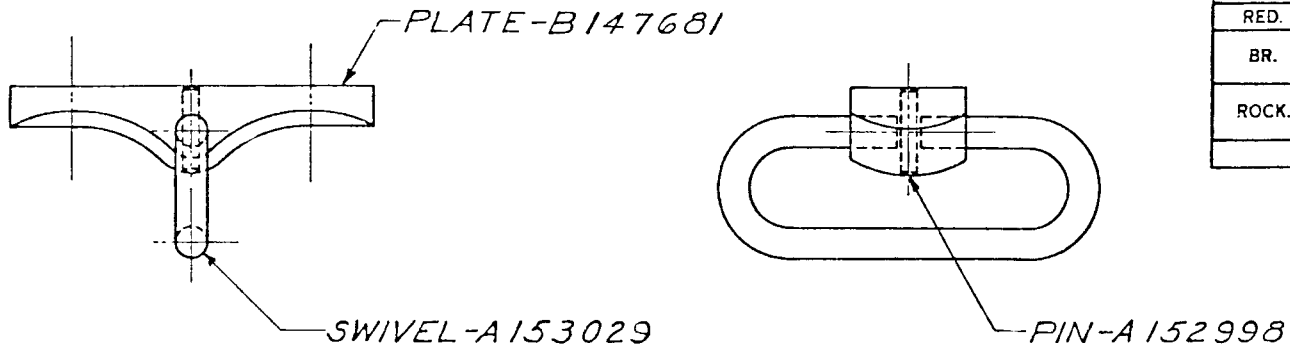

DRG. PERTAINS TO	
51-63	.45 S.M.G.-M28A1
C64381	GRIP, FORE, HORI-
	ZONTAL, ASSEMBLY
C64387	STOCK, ASSEMBLY

SWIVEL, SLING, ASSEMBLY ~~B147692~~ 6147692

LIST OF COMPONENTS

1	2	3	4
LINE NUMBER	DRAWING NUMBER OR PIECE MARK	NAME OF COMPONENT	NO. REQUIRED PER UNIT
1	B147692	SWIVEL, SLING, ASSEMBLY	2
2		COMPOSED OF:-	
3	A152998	1-PIN, SLING SWIVEL *	
4	B147681	1-PLATE, SLING SWIVEL *	
5	A153029	1-SWIVEL, SLING *	
6			
7			

* [illegible] ISSUED FOR FIELD MAINTENANCE EXCEPT AS COMPONENTS OF AUTHORIZED ASSEMBLIES.

0 1 2 3 4 INCHES

B6147692

REF. DRG. A.O.C. 451-24

~~B147692~~

DFTSMAN	TRACER	LDG. DFTSMAN
W.L.M.	W.L.M.	C.J.T.
CHECKER		CHIEF DFTSMAN
C.M.	E.G.W.	F.A.

SUBMITTED:-

LT. COL. ORD. DEPT. U. S. A.

APPROVED BY ORDER OF THE CHIEF OF ORDNANCE:-

COL. ORD. DEPT. U. S. A.

ORDNANCE DEPT., U. S. A.

SUPERSEDES B147692